

Date: Thursday, 6/15/2006 1:52:52 PM  
 User: Kim Johnston

## Process Sheet

|                       |  |                  |                 |
|-----------------------|--|------------------|-----------------|
| Customer              | : CU-DAR001 Dart Helicopters Services  | Drawing Name     | : STEP WELDMENT |
| Job Number            | : 27603  |                  |                 |
| Estimate Number       | : 10748  |                  |                 |
| P.O. Number           | : N/A  | Part Number      | : D34635        |
| This Issue            | : 6/15/2006 S.O. No. : N/A   | Drawing Number   | : D3463 REV.B   |
| Prsht Rev.            | : NC   | Project Number   | : N/A           |
| First Issue           | : N/A Type : PURCHASED PARTS   | Drawing Revision | : B             |
| Previous Run          | : 25529  | Material         | : N/A           |
| Written By            | : <u>See Comment Below</u>   | Due Date         | : 6/30/2006     |
| Checked & Approved By | : <u>See Comment Below</u>   | Qty:             | 4 Um: Each      |
| Comment               | : EST REV. A 05.11.18 NEW ISSUE EC<br>Est Rev:B Now on Waterjet 06-06-15 JLM |                  |                 |

## Additional Product

Job Number:



|         |                       |               |
|---------|-----------------------|---------------|
| Seq. #: | Machine Or Operation: | Description : |
|---------|-----------------------|---------------|

|     |           |                    |
|-----|-----------|--------------------|
| 1.0 | M304S16GA | 304/316 .063 Sheet |
|-----|-----------|--------------------|



Comment: Qty.: 0.0117 sf(s)/Unit Total : 0.0466 sf(s)  
 304/316 .063 Sheet  
 (M304S16GA)  
 Batch: MT106

|     |           |                |
|-----|-----------|----------------|
| 2.0 | WATER JET | FLOW WATER JET |
|-----|-----------|----------------|



Comment: FLOW WATER JET  
 1-Cut as per Dwg D3463  
 Dwg Rev: B  
 Prog Rev: B

2-Deburr if necessary

SAD 06:06:19

④

|     |     |  |
|-----|-----|--|
| 3.0 | QC2 | INSPECT PARTS AS THEY COME OFF MACHINE |
|-----|-----|--|



Comment: INSPECT PARTS AS THEY COME OFF MACHINE

SAD 06:06:19

④

|     |     |              |
|-----|-----|--------------|
| 4.0 | QC8 | SECOND CHECK |
|-----|-----|--------------|



Comment: SECOND CHECK

See Comment Below

|     |             |                       |
|-----|-------------|-----------------------|
| 5.0 | PACKAGING 1 | PACKAGING RESOURCE #1 |
|-----|-------------|-----------------------|



Comment: PACKAGING RESOURCE #1  
 Identify and Stock  
 Location: ST438

See Comment Below

④

| W/O: |      | WORK ORDER CHANGES |    |      |     |                                 |                          |
|------|------|--------------------|----|------|-----|---------------------------------|--------------------------|
| DATE | STEP | PROCEDURE CHANGE   | By | Date | Qty | Approval<br>Mfg / Design<br>Mgr | Approval<br>QC Inspector |
|      |      |                    |    |      |     |                                 |                          |
|      |      |                    |    |      |     |                                 |                          |

| NCR: |      | WORK ORDER NON-CONFORMANCE (NCR) |                             |                                  |                |                           |                        |                          |
|------|------|----------------------------------|-----------------------------|----------------------------------|----------------|---------------------------|------------------------|--------------------------|
| DATE | STEP | Description of NC<br>Section A   | Corrective Action Section B |                                  |                | Verification<br>Section C | Approval<br>Design Mgr | Approval<br>QC Inspector |
|      |      |                                  | Initial<br>Design Mgr       | Action Description<br>Design Mgr | Sign &<br>Date |                           |                        |                          |
|      |      |                                  |                             |                                  |                |                           |                        |                          |
Part No: \_\_\_\_\_ PAR #: \_\_\_\_\_ Fault Category: \_\_\_\_\_ NCR: Yes ☐ No ☒ DQA:  Date: 06/06/27

NOTE: Date & initial all entries

QA: N/C Closed: \_\_\_\_\_ Date: \_\_\_\_\_

Date: Thursday, 6/15/2006 1:52:52 PM  
User: Kim Johnston

## Process Sheet

Customer: CU-DAR001 Dart Helicopters Services

Drawing Name: STEP WELDMENT

Job Number: 27603

Part Number: D34635

Job Number:



Seq. #:

Machine Or Operation:

Description :

6.0

DC

DOCUMENT CONTROL



Comment: DOCUMENT CONTROL  
Inspection Level 21

2006/06/27 (4)

Job Completion



u X627

| W/O: |      | WORK ORDER CHANGES |    |      |     |                                 |                          |
|------|------|--------------------|----|------|-----|---------------------------------|--------------------------|
| DATE | STEP | PROCEDURE CHANGE   | By | Date | Qty | Approval<br>Mfg / Design<br>Mgr | Approval<br>QC Inspector |
|      |      |                    |    |      |     |                                 |                          |
|      |      |                    |    |      |     |                                 |                          |

| NCR: |      | WORK ORDER NON-CONFORMANCE (NCR) |                             |                                  |                |                           |                        |                          |
|------|------|----------------------------------|-----------------------------|----------------------------------|----------------|---------------------------|------------------------|--------------------------|
| DATE | STEP | Description of NC<br>Section A   | Corrective Action Section B |                                  |                | Verification<br>Section C | Approval<br>Design Mgr | Approval<br>QC Inspector |
|      |      |                                  | Initial<br>Design Mgr       | Action Description<br>Design Mgr | Sign &<br>Date |                           |                        |                          |
|      |      |                                  |                             |                                  |                |                           |                        |                          |

Part No: \_\_\_\_\_ PAR #: \_\_\_\_\_ Fault Category: \_\_\_\_\_ NCR: Yes No DQA: \_\_\_\_\_ Date: \_\_\_\_\_

NOTE: Date & initial all entries

QA: N/C Closed: \_\_\_\_\_ Date: \_\_\_\_\_

**DART**

|                         |                |  |                        |
|-------------------------|----------------|--|------------------------|
| DESIGN<br>RF            | DRAWN BY<br>RF | <b>DART AEROSPACE LTD</b><br>HAWKESBURY, ONTARIO, CANADA |                        |
| CHECKED<br>#            | APPROVED<br>#  | DRAWING NO.<br><b>D3463</b>                              | REV. B<br>SHEET 1 OF 4 |
| DATE<br><b>05.12.05</b> |                | TITLE<br><b>STEP WELDMENT</b>                            | SCALE<br>1:8           |
| A                       | 05.09.20       | NEW ISSUE  |                        |
| B                       | 05.12.05       | REVISE DIM.; D3463-5 WAS D3463-5F                        |                        |

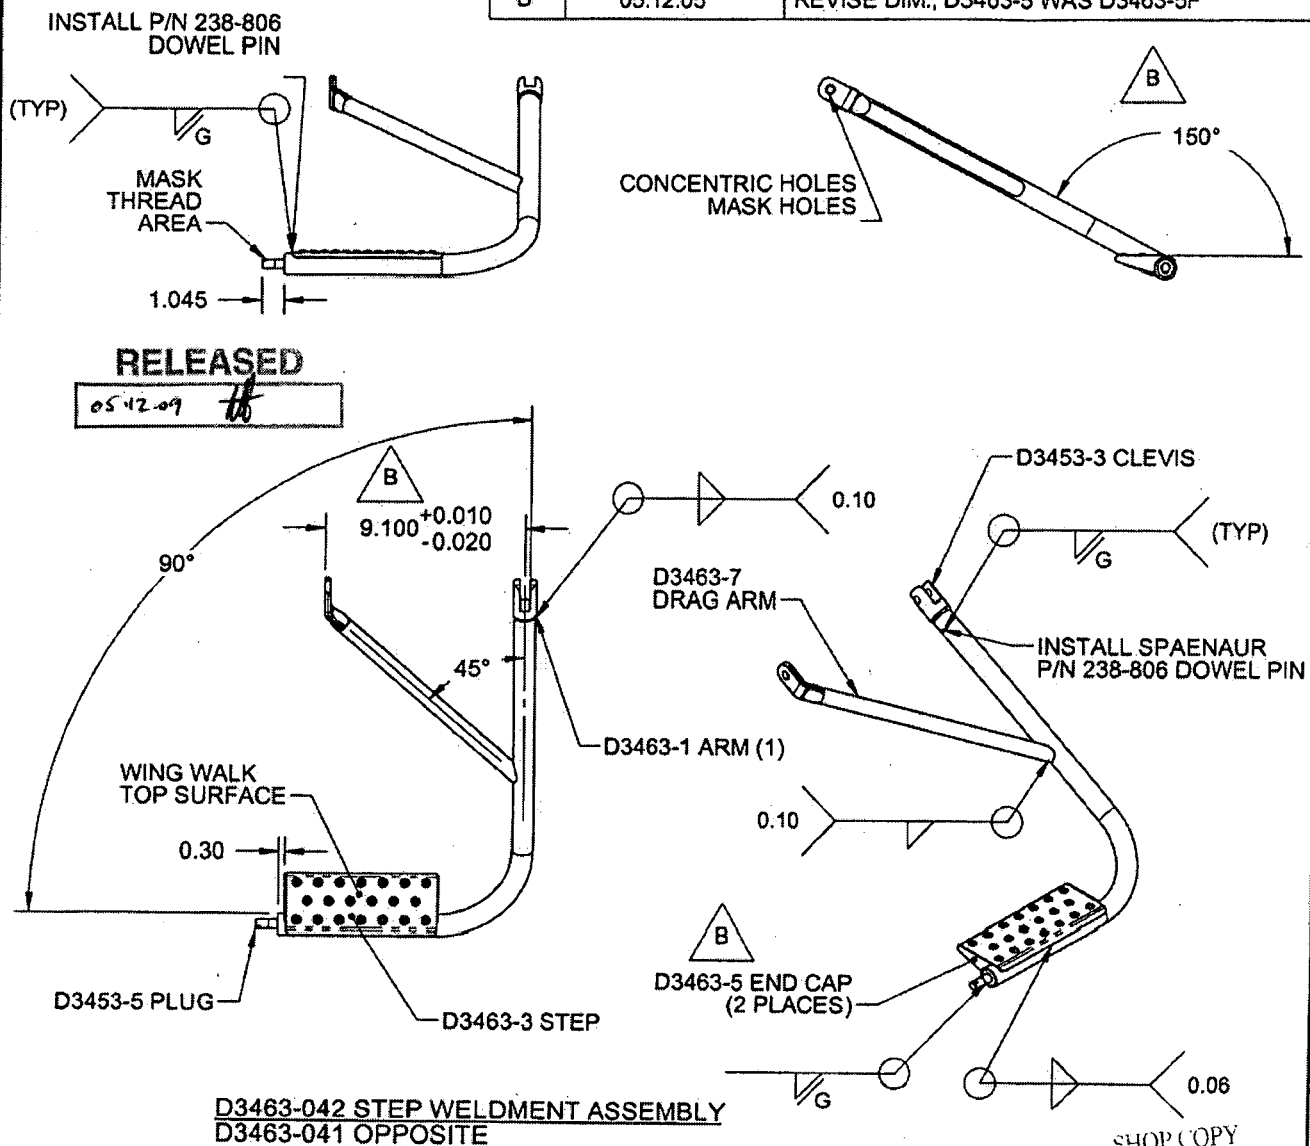**NOTES:**

- 1) WELD PER DART QSI 004
- 2) FINISH: POWDER COAT WHITE (4.3.5.2) PER DART QSI 005 4.3  
BLACK ANTI-SKID PAINT PER DART QSI 005 4.4
- 3) TOLERANCES ARE PER DART QSI 018 UNLESS OTHERWISE NOTED
- 4) ALL DIMENSIONS ARE IN INCHES
- 5) BREAK ALL UNMARKED SHARP EDGES 0.005 TO 0.010
- 6) IDENTIFY WITH DART P/N USING FINE POINT PERMANENT INK MARKER


SHOP COPY  
RETURN TO  
ENGINEERING  
UNCONTROLLED COPY  
SUBJECT TO AMENDMENT  
WITHOUT NOTICE  
WORK ORDER  
NO. **27603**

COPYRIGHT © 2005 BY DART AEROSPACE LTD.

THIS DOCUMENT IS PRIVATE AND CONFIDENTIAL AND IS SUPPLIED ON THE EXPRESS CONDITION THAT IT IS NOT TO BE USED FOR ANY PURPOSE OR COPIED OR COMMUNICATED TO ANY OTHER PERSON WITHOUT WRITTEN PERMISSION FROM DART AEROSPACE LTD.

**DART**

|                               |                                |  |                        |
|-------------------------------|--------------------------------|--|------------------------|
| DESIGN<br>RF                  | DRAWN BY<br>RF                 | <b>DART AEROSPACE LTD</b><br>HAWKESBURY, ONTARIO, CANADA |                        |
| CHECKED<br><i>[Signature]</i> | APPROVED<br><i>[Signature]</i> | DRAWING NO.<br><b>D3463</b>                              | REV. B<br>SHEET 2 OF 4 |
| DATE<br><b>05.12.05</b>       | TITLE<br><b>STEP WELDMENT</b>  |  | SCALE<br>1:4           |

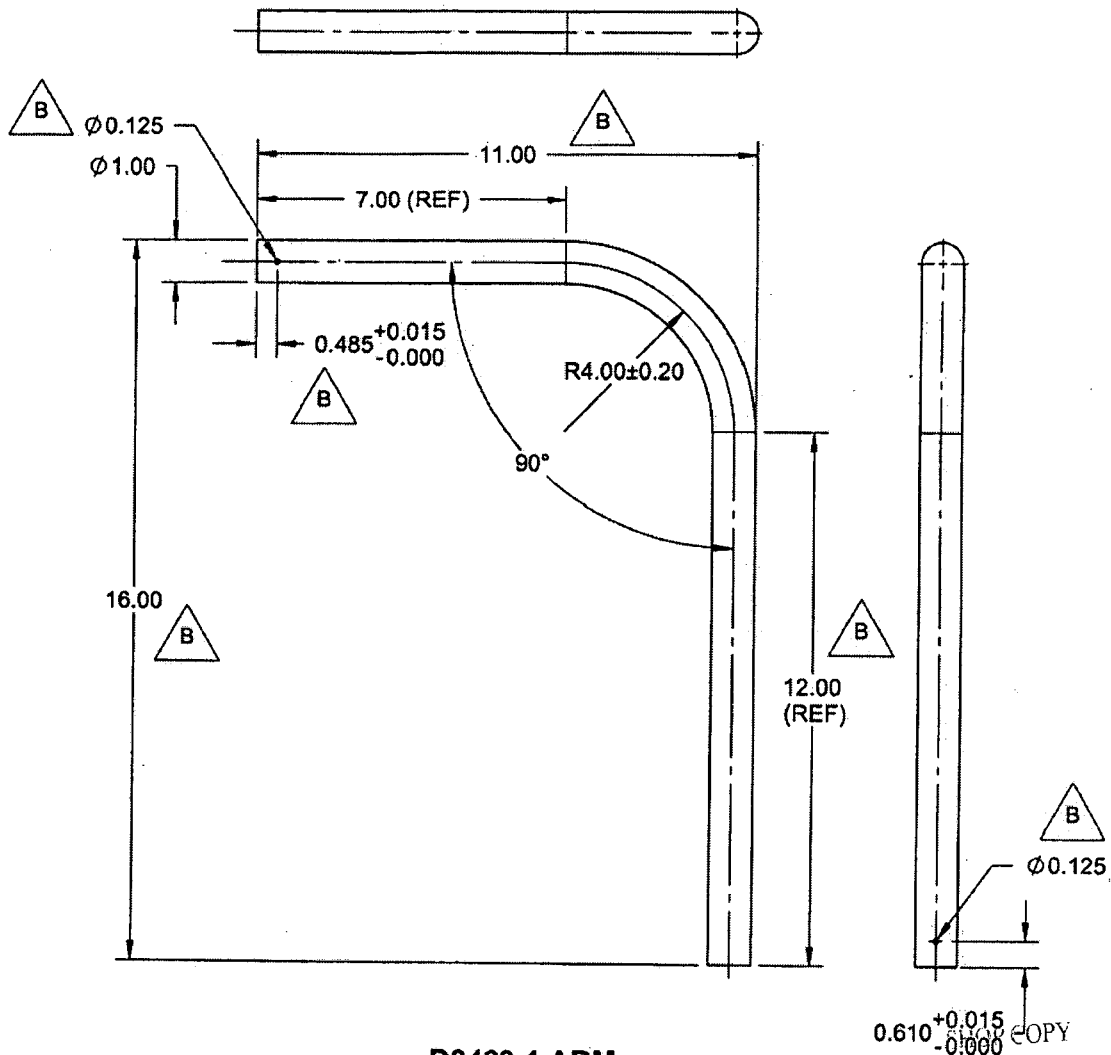
**RELEASED**05.12.09 *[Signature]***D3463-1 ARM****NOTES:**

- 1) MATERIAL: AISI 316/304 SS SEAMLESS TUBING (REF. DART SPEC. M304TR1.000W120)
- 2) FINISH: NONE
- 3) TOLERANCES ARE PER DART QSI 018 UNLESS OTHERWISE NOTED
- 4) ALL DIMENSIONS ARE IN INCHES
- 5) BREAK ALL UNMARKED SHARP EDGES 0.005 TO 0.025

0.610 <sup>+0.015</sup>/<sub>-0.000</sub> COPY  
RETURN TO  
ENGINEERING  
UNCONTROLLED COPY  
SUBJECT TO AMENDMENT  
WITHOUT NOTICE  
WORK ORDER  
NO. **27603**

COPYRIGHT © 2005 BY DART AEROSPACE LTD.

THIS DOCUMENT IS PRIVATE AND CONFIDENTIAL AND IS SUPPLIED ON THE EXPRESS CONDITION THAT IT IS NOT TO BE USED FOR ANY PURPOSE OR COPIED OR COMMUNICATED TO ANY OTHER PERSON WITHOUT WRITTEN PERMISSION FROM DART AEROSPACE LTD.

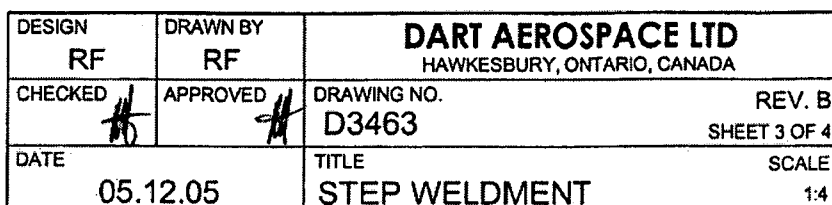

05.12.09 ~~11~~



1) MATERIAL: AISI 316/304 SS SEAMLESS TUBING (REF. DART SPEC. M  
2) FINISH: NONE  
3) TOLERANCES ARE PER DART QSI 018 UNLESS OTHERWISE NOTED  
4) ALL DIMENSIONS ARE IN INCHES  
5) BREAK ALL UNMARKED SHARP EDGES 0.005 TO 0.010

SHOP COPY  
RETURN TO  
04TR0.750W(120)  
UNCONTROLLED COPY  
SUBJECT TO AMENDMENT  
WITHOUT NOTICE  
WORK ORDER  
NO. 27603

**COPYRIGHT © 2005 BY DART AEROSPACE LTD.**


THIS DOCUMENT IS PRIVATE AND CONFIDENTIAL AND IS SUPPLIED ON THE EXPRESS CONDITION THAT IT IS NOT TO BE USED FOR ANY PURPOSE OR COPIED OR COMMUNICATED TO ANY OTHER PERSON WITHOUT WRITTEN PERMISSION FROM DART AEROSPACE LTD.




|                  |                |   |                        |
|------------------|----------------|---|------------------------|
| DESIGN<br>RF     | DRAWN BY<br>RF | DART AEROSPACE LTD<br>HAWKESBURY, ONTARIO, CANADA |                        |
| CHECKED<br>#     | APPROVED<br>#  | DRAWING NO.<br>D3463                              | REV. B<br>SHEET 4 OF 4 |
| DATE<br>05.12.05 |                | TITLE<br>STEP WELDMENT                            | SCALE<br>1:2           |

RELEASED


05.12.09 #

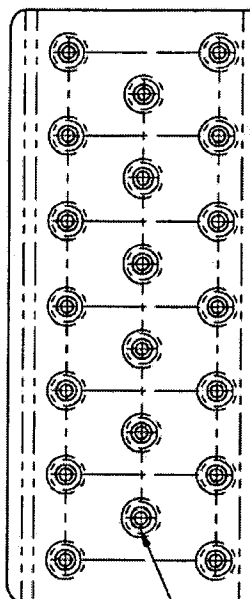


FORM USING  
D3463-3T1

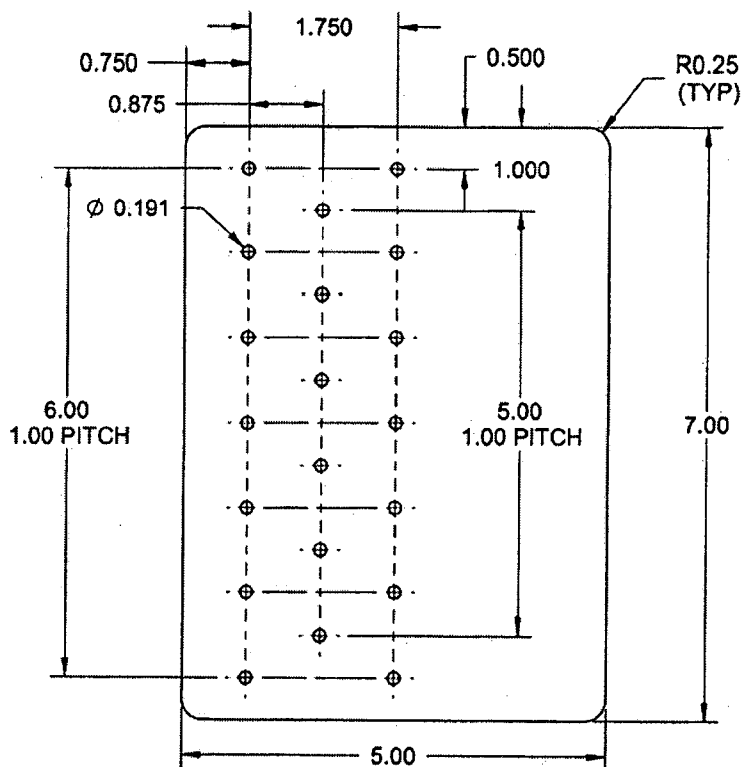

**D3463-3F FLAT PATTERN**

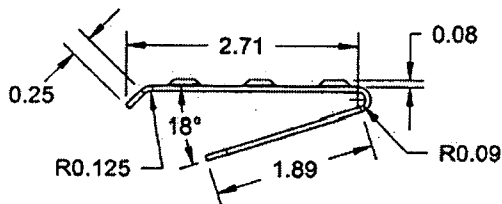

**D3463-3 STEP**

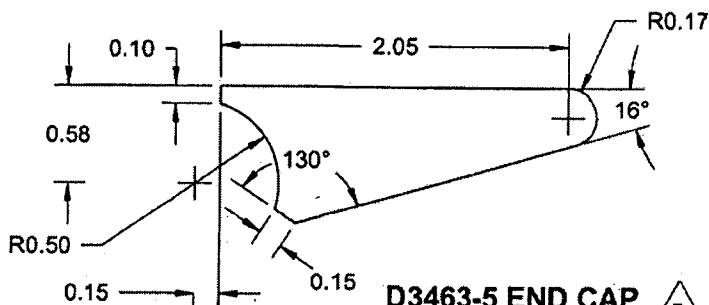

**D3463-5 END CAP**  
SCALE 1:1

**NOTES:**

- 1) MATERIAL: AISI 304/316 SS SHEET, 0.060 THICK (REF. DART SPEC. M304S16GA)
- 2) FINISH: NONE
- 3) TOLERANCES ARE PER DART QSI 018 UNLESS OTHERWISE NOTED
- 4) ALL DIMENSIONS ARE IN INCHES
- 5) BREAK ALL UNMARKED SHARP EDGES 0.005 TO 0.010

SHOP COPY

RETURN TO

ENGINEERING

UNCONTROLLED COPY

SUBJECT TO AMENDMENT

WITHOUT NOTICE

WORK ORDER

NO.

22603

COPYRIGHT © 2005 BY DART AEROSPACE LTD.

THIS DOCUMENT IS PRIVATE AND CONFIDENTIAL AND IS SUPPLIED ON THE EXPRESS CONDITION THAT IT IS NOT TO BE USED FOR ANY PURPOSE OR COPIED OR COMMUNICATED TO ANY OTHER PERSON WITHOUT WRITTEN PERMISSION FROM DART AEROSPACE LTD.



